


DRAWING NUMBER

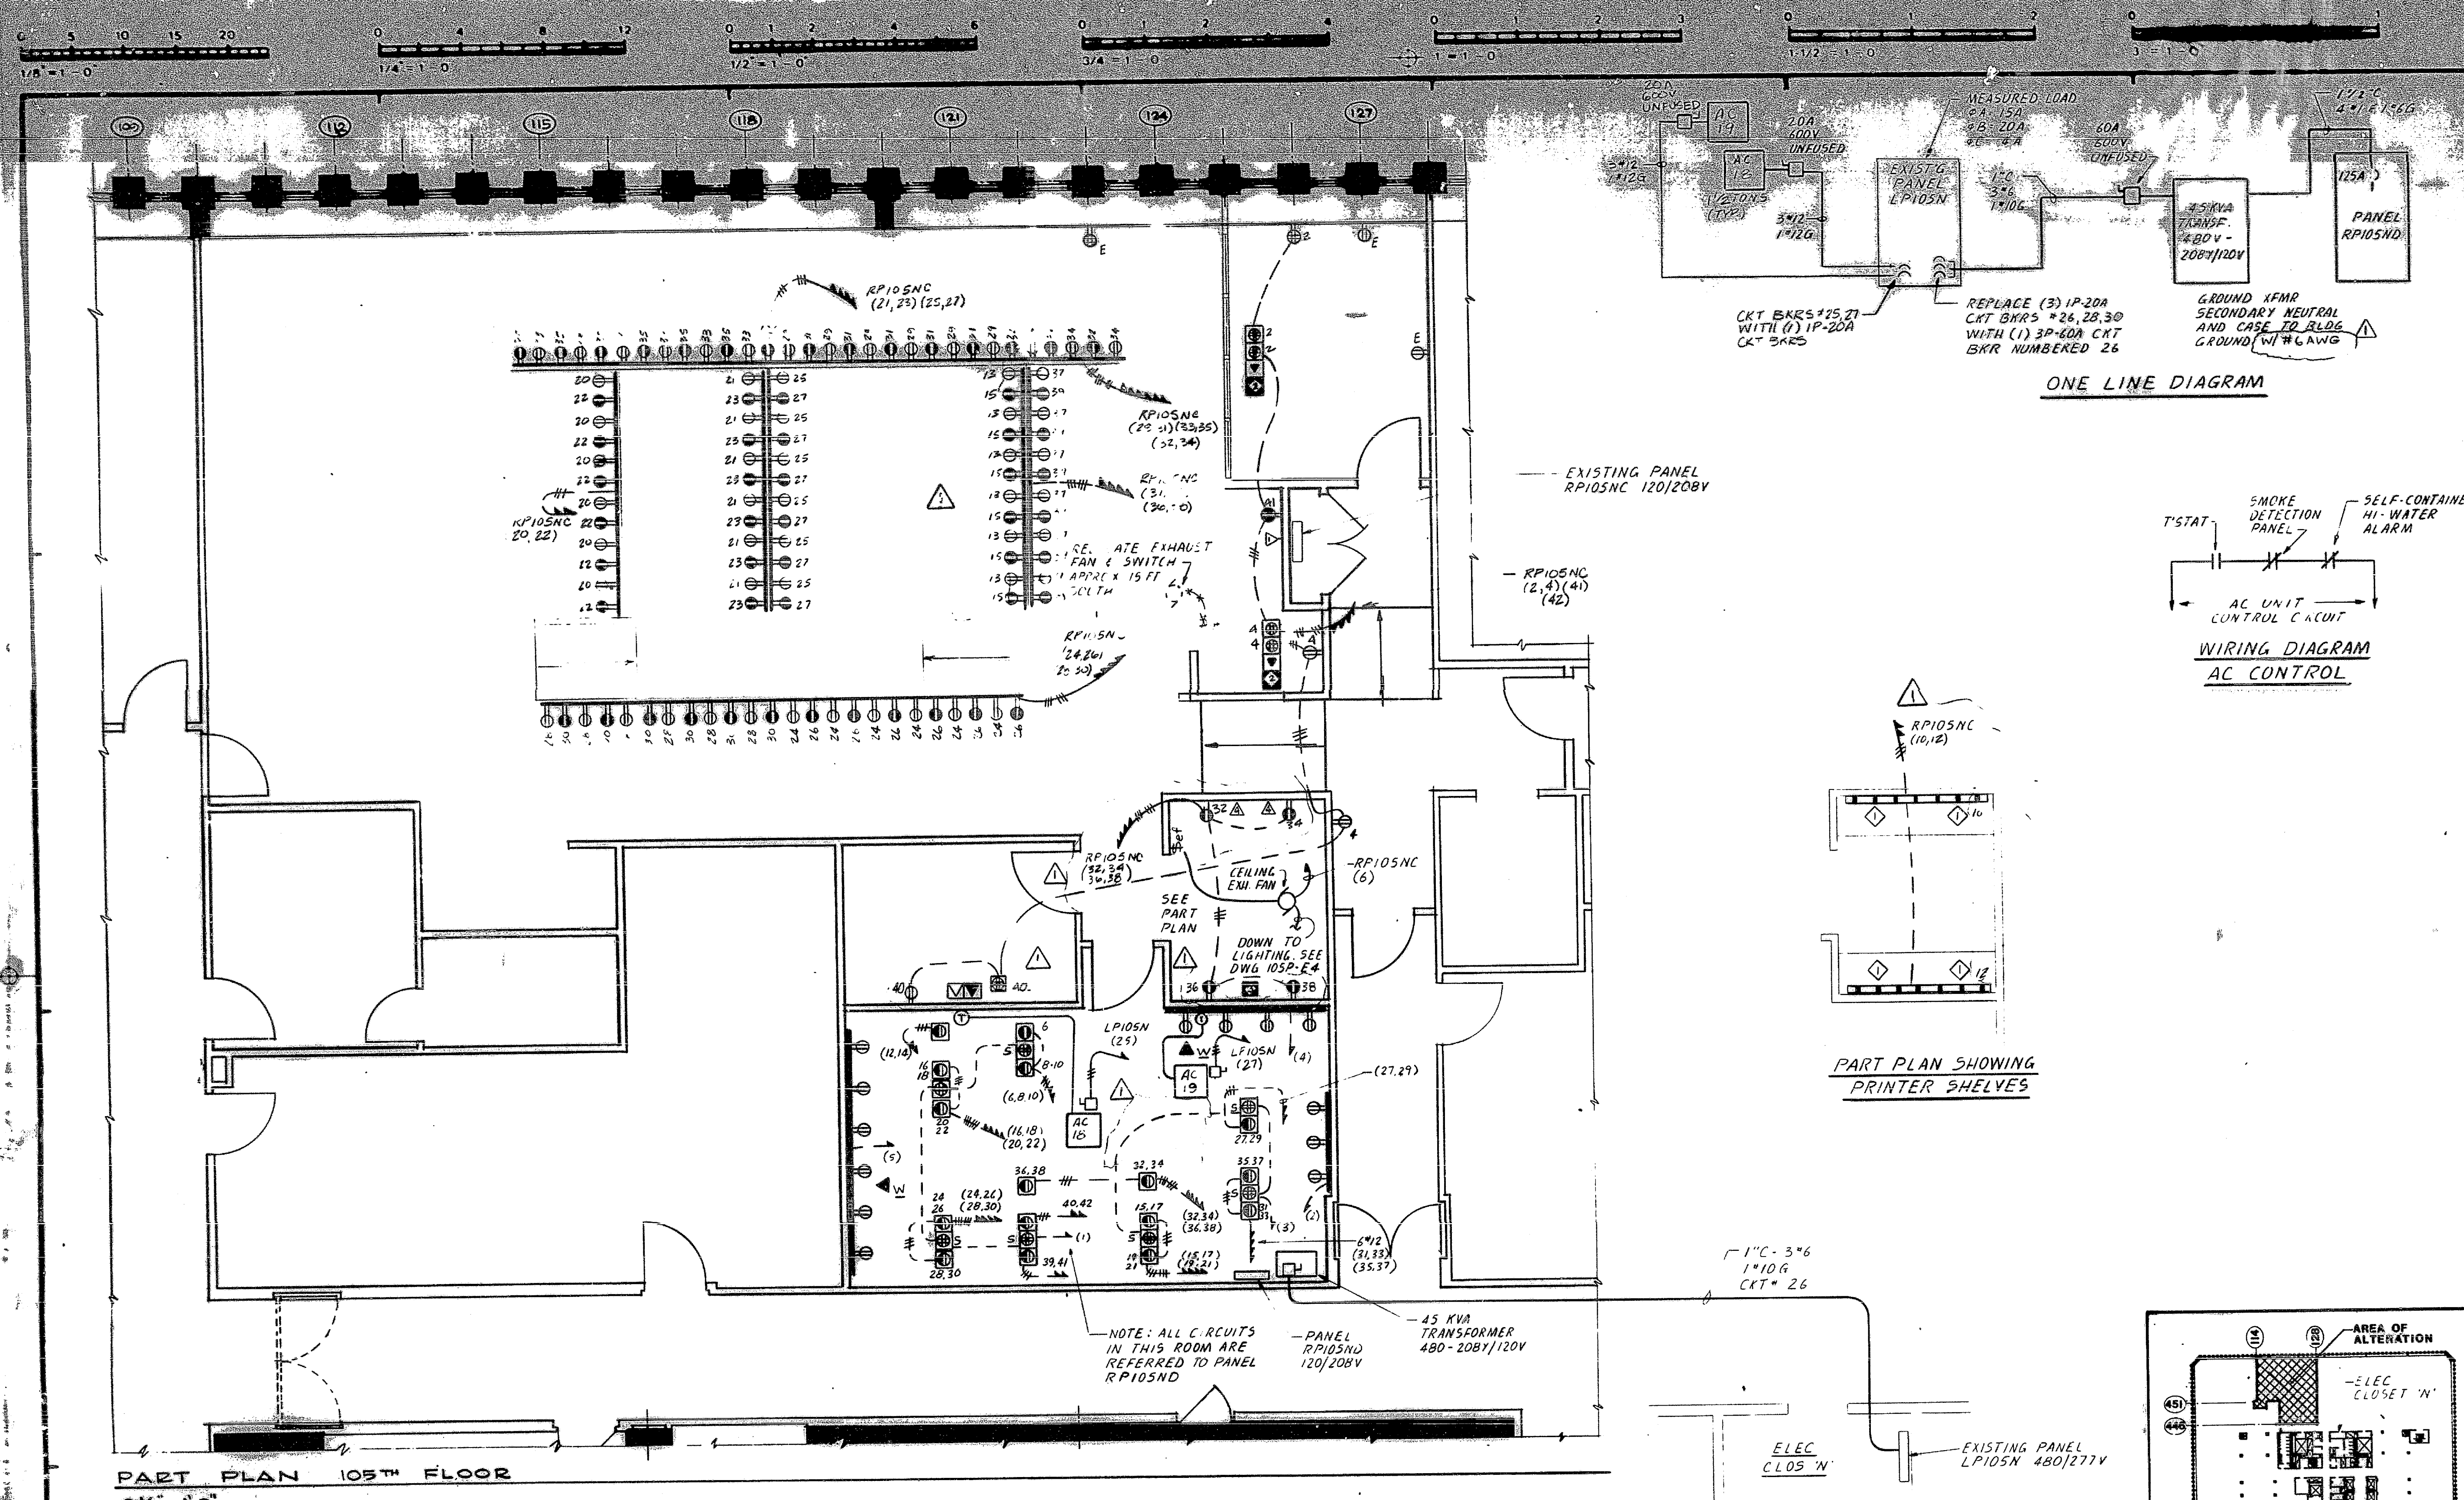


**FRONIERE ARCHITECTS**

205 LEXINGTON AVE  
NEW YORK NY 10016  
TEL (212) 889 9550


**JOHN C. WESTRICK & ASSOCIATES**  
**CONSULTING ENGINEERS**

2110 MAPLE AVE. SOUTH PLAINFIELD, N. J.  
Q7060 201 581-4170

ONE LINE DIAGRAM

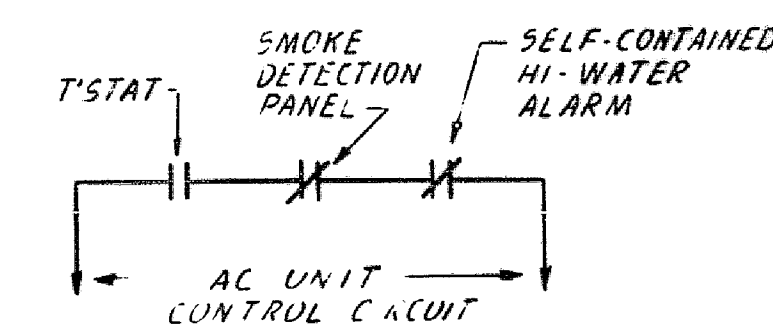

### WIRING DIAGRAM AC CONTROL

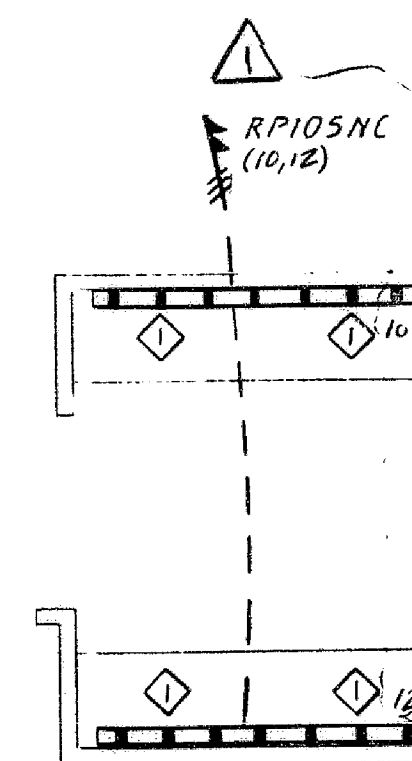

PART PLAN SHOWING  
PRINTER SHELVES

DATE	ISSUED TO	PR	TR
3/22/91	PORT AUTHORITY FOR APPROVAL	10	1
3/22/91	FSC FOR RECORD	5	
	CONTRACTORS FOR BIDDING	4	4
5/3/91	P.A. FOR APPROVAL	10	
6-19-91	PORT AUTHORITY	10	
10-21-91	P.A. AS BUILT DRAWING	10	1

JOHN C. WESTRICK & ASSOCIATES  
CONSULTING ENGINEERS  
2110 MAPLE AVENUE  
SOUTH PLAINFIELD, N.J. 07080  
661-4170

AS BUILT DRAWINGS

Signature \_\_\_\_\_ Date \_\_\_\_\_

1	86-91	1. PLE AS-BUILT CONDITIONS	1E
NO	DATE	REVISION	BY

**CANTOR, FITZGERALD  
SECURITIES CORP.**  
105th FLOOR  
ONE WORLD TRADE CENTER, NEW YORK, N.Y.

**PROPOSED NEW TRADING ROOM**  
**FOR INVESTMENT STRATEGIES**

POWER AND SIGNAL PLAN



PROJECT NO. 91115
SCALE 1/4" = 1'-0"
DRAWN BY GCD
CHECKED BY Jcw
DATE 3-20-91

DRAWING NO.

105P E-5

**KEY PLAN**  
1/64" = 1'-0"

## PHASE

**P**  
**TAA. NO.**

